


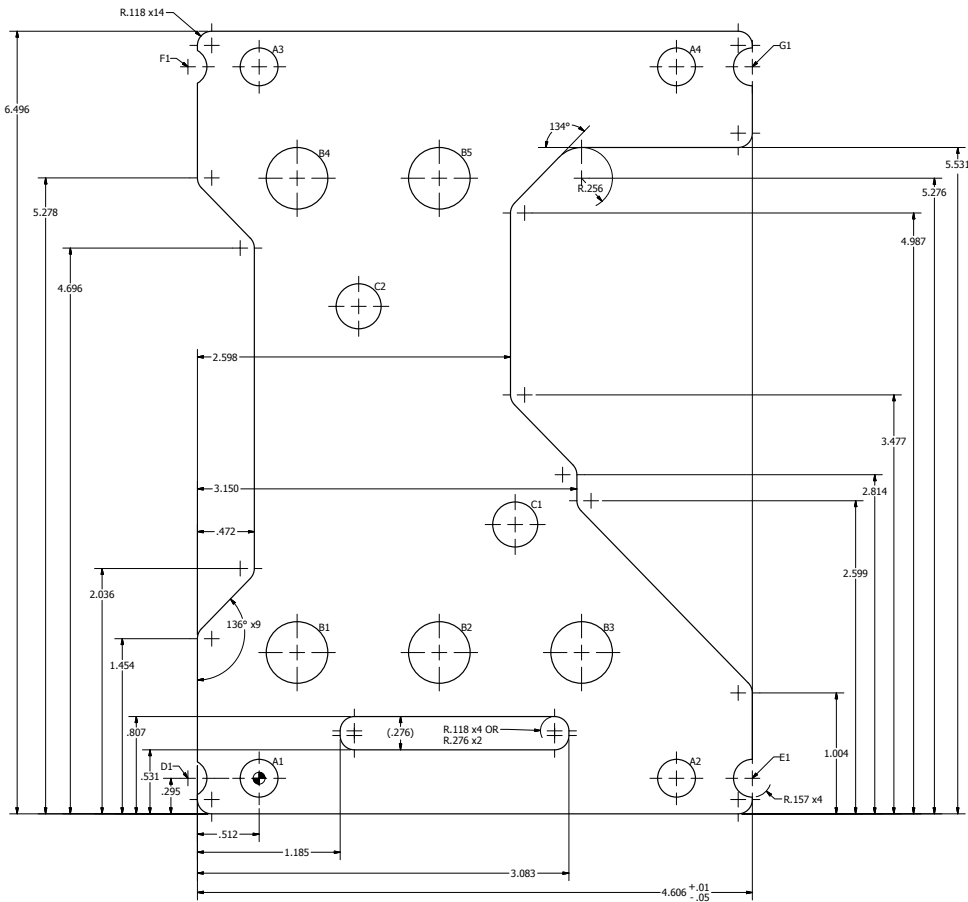

HOLE TABLE			
HOLE	XDIM	YDIM	HOLE DIAMETER
A1	.00	.00	0.315
A2	3.46	.00	0.315
A3	.00	5.91	0.315
A4	3.46	5.91	0.315
B1	.31	1.04	0.512
B2	1.50	1.04	0.512
B3	2.68	1.04	0.512
B4	.31	4.98	0.512
B5	1.50	4.98	0.512
C1	2.13	2.11	0.374
C2	.83	3.92	0.374
D1	-.59	.00	-
E1	4.09	.00	-
F1	-.59	5.91	-
G1	4.09	5.91	-

D1/E1/F1/G1
same diameter

Material: 3003-H14 Aluminum Sheet
 Thickness: 0.125" (~~1/4"~~)
 Finish: RAW
 Unit: Inch
 Tolerance (Hole Diameter): -0.00, +0.02
 Tolerance (X,Y, outside radii): ±0.03"
 See DXF for 2D Flat
 See STEP for 3D

2022FEB01

QTY600

DRAWN John Sullivan	CHECKED 5/9/2021	Please quote at QTY150	
QA		TITLE	
MFG		LIBCM Endplate	
APPROVED		SIZE D	REV A
		DWG NO JTS-LIBCM-001	
		SCALE 2:1	SHEET 1 OF 1